


DEALER NAME: JUST POOLS INC	PROGRAM DATE: 07-10-08 A	MATERIAL TYPE: DACRON	SALES ORDER #: 716262	S50 #50 BRASS ANCHOR: 49	S86 #1 WEB PKT (LF):	S82 #1 CABLE LG (LF):	S460 #1 SPCL CBL (LF):	DESCRIPTION	TOTAL
CUSTOMER NAME: BOHNERT		COVER STYLE: IRREGULAR	SQUARE FEET: 593	S114 9" RUBBER TIE	S87 #2 WEB PKT (LF):	S83 #2 CABLE LG (LF):	S465 #2 SPCL CBL (LF):	(S113) # GROMMETS: 49	
DRAWING DATE: 04/14/2023		CONSTRUCTION: GROMMET	COVER COLOR: CHAR GREY	S60 10" RUBBER TIE 49	S88 #3 WEB PKT (LF):	S84 #3 CABLE LG (LF):	S470 #3 SPCL CBL (LF):	S54 GA 9: 0	
DRAWING NUMBER: 716262_1 LINE #: 1		CROSS WEB: NONE	DXF FILE: YES	S61 15" RUBBER TIE 0	S89 #4 WEB PKT (LF):	S85 #4 CABLE LG (LF):	S475 #4 SPCL CBL (LF):	S53 GA 15: 0	
DRAWING SCALE: 1/4"=1'-0"		OVERLAP: 18		S58 BRASS DECK FLANGE: 49	WEB PKT. (LF):	CABLE LENGTH (LF):			
DRAWN BY: TH RGA#: NA		MATERIAL WIDTH: 74		S51 WOOD DECK ANCHOR: 0				CUT EDGE: 37'-10"	
OLD#: NA YEAR: NA	DACRON	MESH DRAIN: NONE	GROSS SF: 781.23	NUMBER OF SNAPS:		S335 INS. CABLE REINF: 0.52		FINISH COVER: 37'-8"	

EXTRA HARDWARE

BRASS ANCHORS:
10" RUBBER TIES:
15" RUBBER TIES:
SPRINGS:
WOOD DECK ANCHORS:
SS TABS:
GROUND TUBES 9:
GROUND TUBES 15:
SPRING SKID:
FLANGES:
2" RATCHET:
2" RATCHET ASSY:
HILTI HARDWARE:
HILTI SETTING TOOL:
1" RATCHET:
2" WEB:
1" WEB:
1" DRING:
6'-4" WEB:

DEALER/SALES APPROVED 4/18/2023

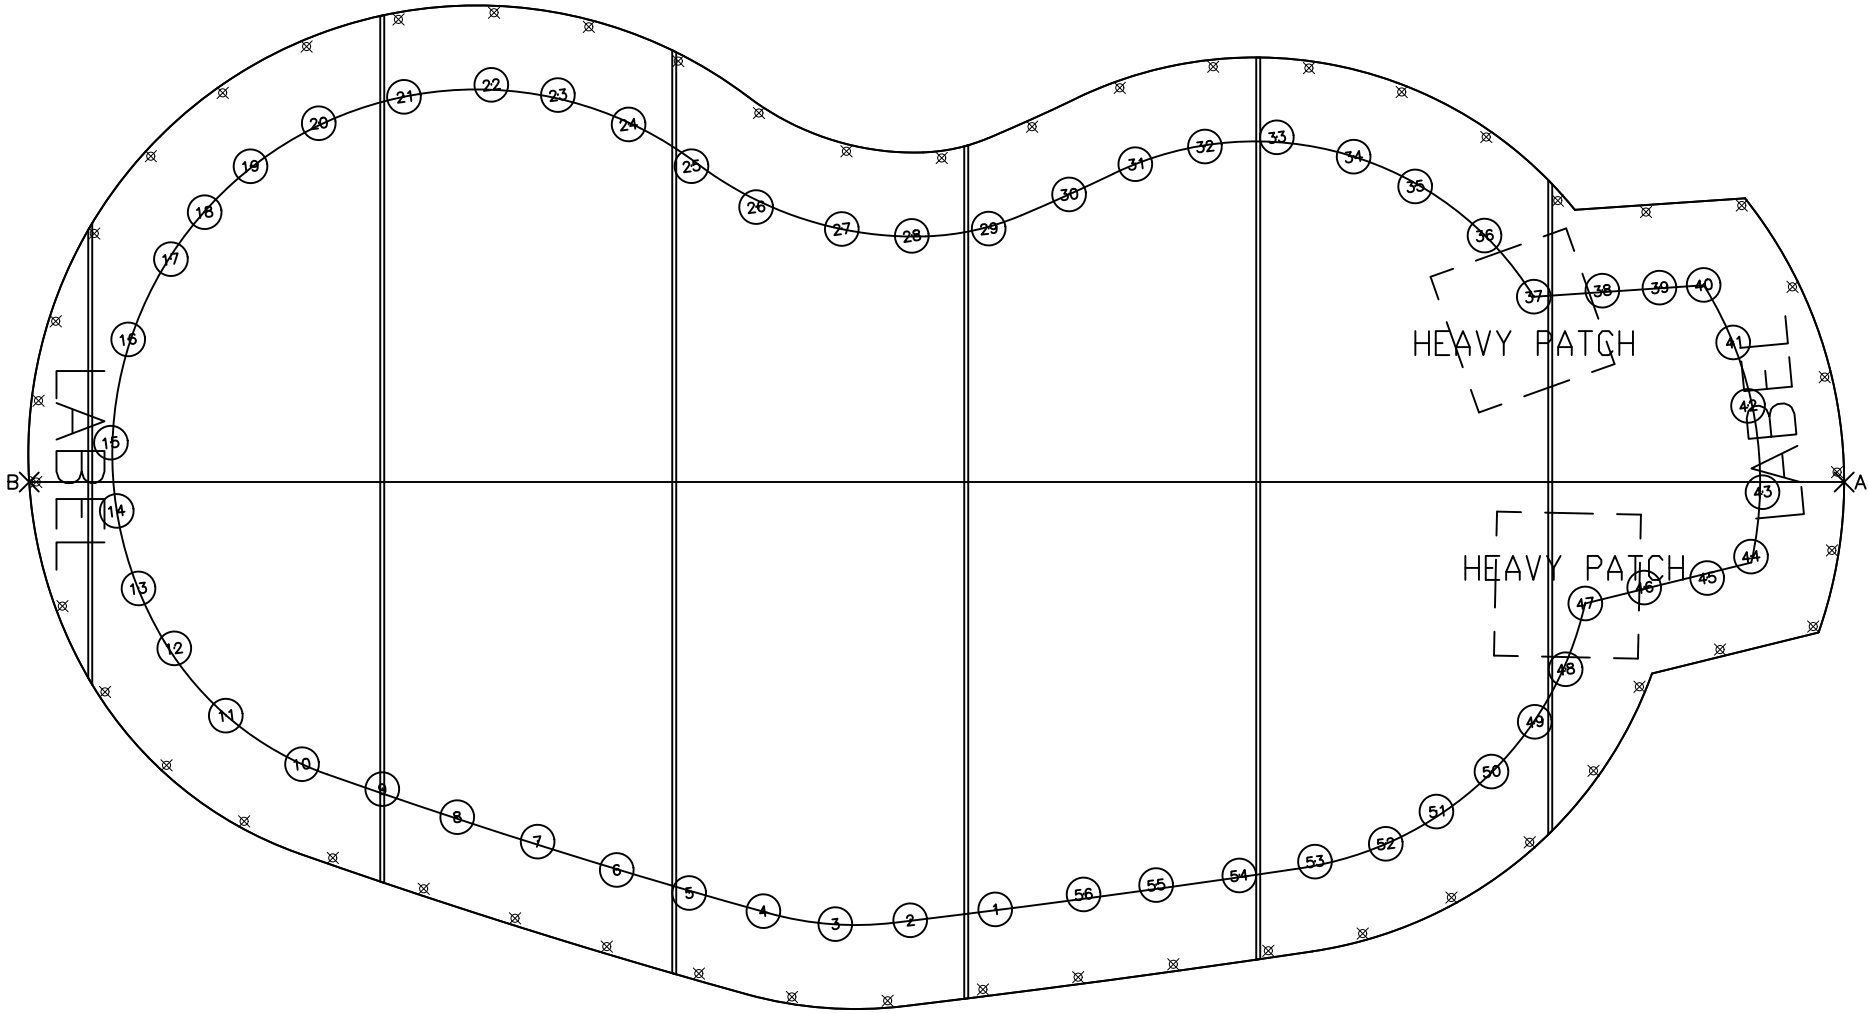

Fabric Lot		Hem	
Cutter		Tack	
Mark up		Vinyl Strap	
Triple Needle/Weld		Tip/Grommet	
Cross Web		Inspect	
Stay Stitch			

A & B DISTANCES AS ENTERED					
#	A	B	#	A	B
1	8'-8"	11'-8"	43	26'-1"	15'-3"
2	7'-8"	13'-2"	44	25'-1"	13'-11"
3	7'-2"	14'-7"	45	24'-1"	13'-2"
4	7'-4"	16'-1"	46	22'-11"	12'-7"
5	7'-11"	17'-8"	47	21'-9"	12'
6	8'-10"	19'-3"	48	20'-7"	10'-7"
7	10'-1"	21'	49	19'-5"	9'-5"
8	11'-5"	22'-9"	50	18'-1"	8'-4"
9	12'-10"	24'-5"	51	16'-8"	7'-7"
10	14'-4"	26'-2"	52	15'-5"	7'-2"
11	16'-2"	28'	53	14'	7'-5"
12	17'-11"	29'-6"	54	12'-7"	8'-1"
13	19'-4"	30'-8"	55	11'-2"	9'-2"
14	20'-10"	31'-9"	56	10'	10'-3"
15	22'	32'-6"			
16	23'-6"	33'-3"			
17	24'-5"	33'-5"			
18	24'-11"	33'-5"			
19	25'-4"	33'-3"			
20	25'-7"	32'-9"			
21	25'-6"	31'-10"			
22	25'-3"	30'-9"			
23	24'-9"	29'-8"			
24	23'-11"	28'-3"			
25	22'-11"	26'-9"			
26	22'	25'-3"			
27	21'-7"	23'-10"			
28	21'-7"	22'-11"			
29	22'	22'-3"			
30	23'-1"	22'-2"			
31	24'-1"	22'-3"			
32	24'-11"	22'-2"			
33	25'-8"	22'			
34	26'	21'-4"			
35	26'-1"	20'-7"			
36	26'	19'-6"			
37	25'-7"	18'-3"			
38	26'-7"	18'-6"			
39	27'-5"	18'-9"			
40	28'-1"	19'			
41	27'-8"	18'			
42	27'	16'-10"			