DEALER NAME:	PARKERS POOL	PROGRAM DATE: 07-10-08 A	MATERIAL TYPE:	DEFENDER	SALES ORDER #:	717167	S50 #50 BRASS ANCHOR:	0	S86 #1 WEB PKT (LF):		S82 #1 CABLE LG (LF):		S460 #1 SPCL CBL (LF):	
CUSTOMER NAME:	MEEHAN		COVER STYLE:	IRREGULAR	SQUARE FEET:	821	S55 SPRING W/O RING:	49	S87 #2 WEB PKT (LF):		S83 #2 CABLE LG (LF):		S465 #2 SPCL CBL (LF):	
DRAWING DATE:	05/16/2023		CONSTRUCTION:	SPRING	COVER COLOR:	GREEN D-MESH	S59 SPRING COVER:	49	S88 #3 WEB PKT (LF):		S84 #3 CABLE LG (LF):		S470 #3 SPCL CBL (LF):	
DRAWING NUMBER:	717167_1 LINE #: 1		CROSS WEB:	36	DXF FILE:	YES	S58 BRASS DECK FLANGE:	0	S89 #4 WEB PKT (LF):		S85 #4 CABLE LG (LF):		S475 #4 SPCL CBL (LF):	
DRAWING SCALE:	1/4"=1'-0"		OVERLAP:	.25	GROSS SF:	1127.60	S51 WOOD DECK ANCHOR:	0	WEB PKT. (LF):		CABLE LENGTH (LF):			
DRAWN BY:	TH RGA#: 17767		MATERIAL WIDTH:	75			S57 SS TAB:	0	S80 TIPS: 0.3	49	14.7			
OLD#:	NA YEAR: NA	MESH	MESH DRAIN:	NONE			NUMBER OF SNAPS:		S79 VINYL STRIPS: 1.15	44	54.0		S335 INS. CABLE REINF:	0.67

EXTRA HARDWARE

BRASS ANCHORS:
10" RUBBER TIES:
15" RUBBER TIES:
SPRINGS:
WOOD DECK ANCHORS:
SS TABS:
GROUND TUBES 9:
GROUND TUBES 15:
SPRING SKID:
FLANGES:
2" RATCHET:
2" RATCHET ASSY:
HILTI HARDWARE:
HILTI SETTING TOOL:
1" RATCHET:
2" WEB:
1" WEB:
1" DRING:
6'-4" WEB:

MATCH WEB SPACING PER DEALER

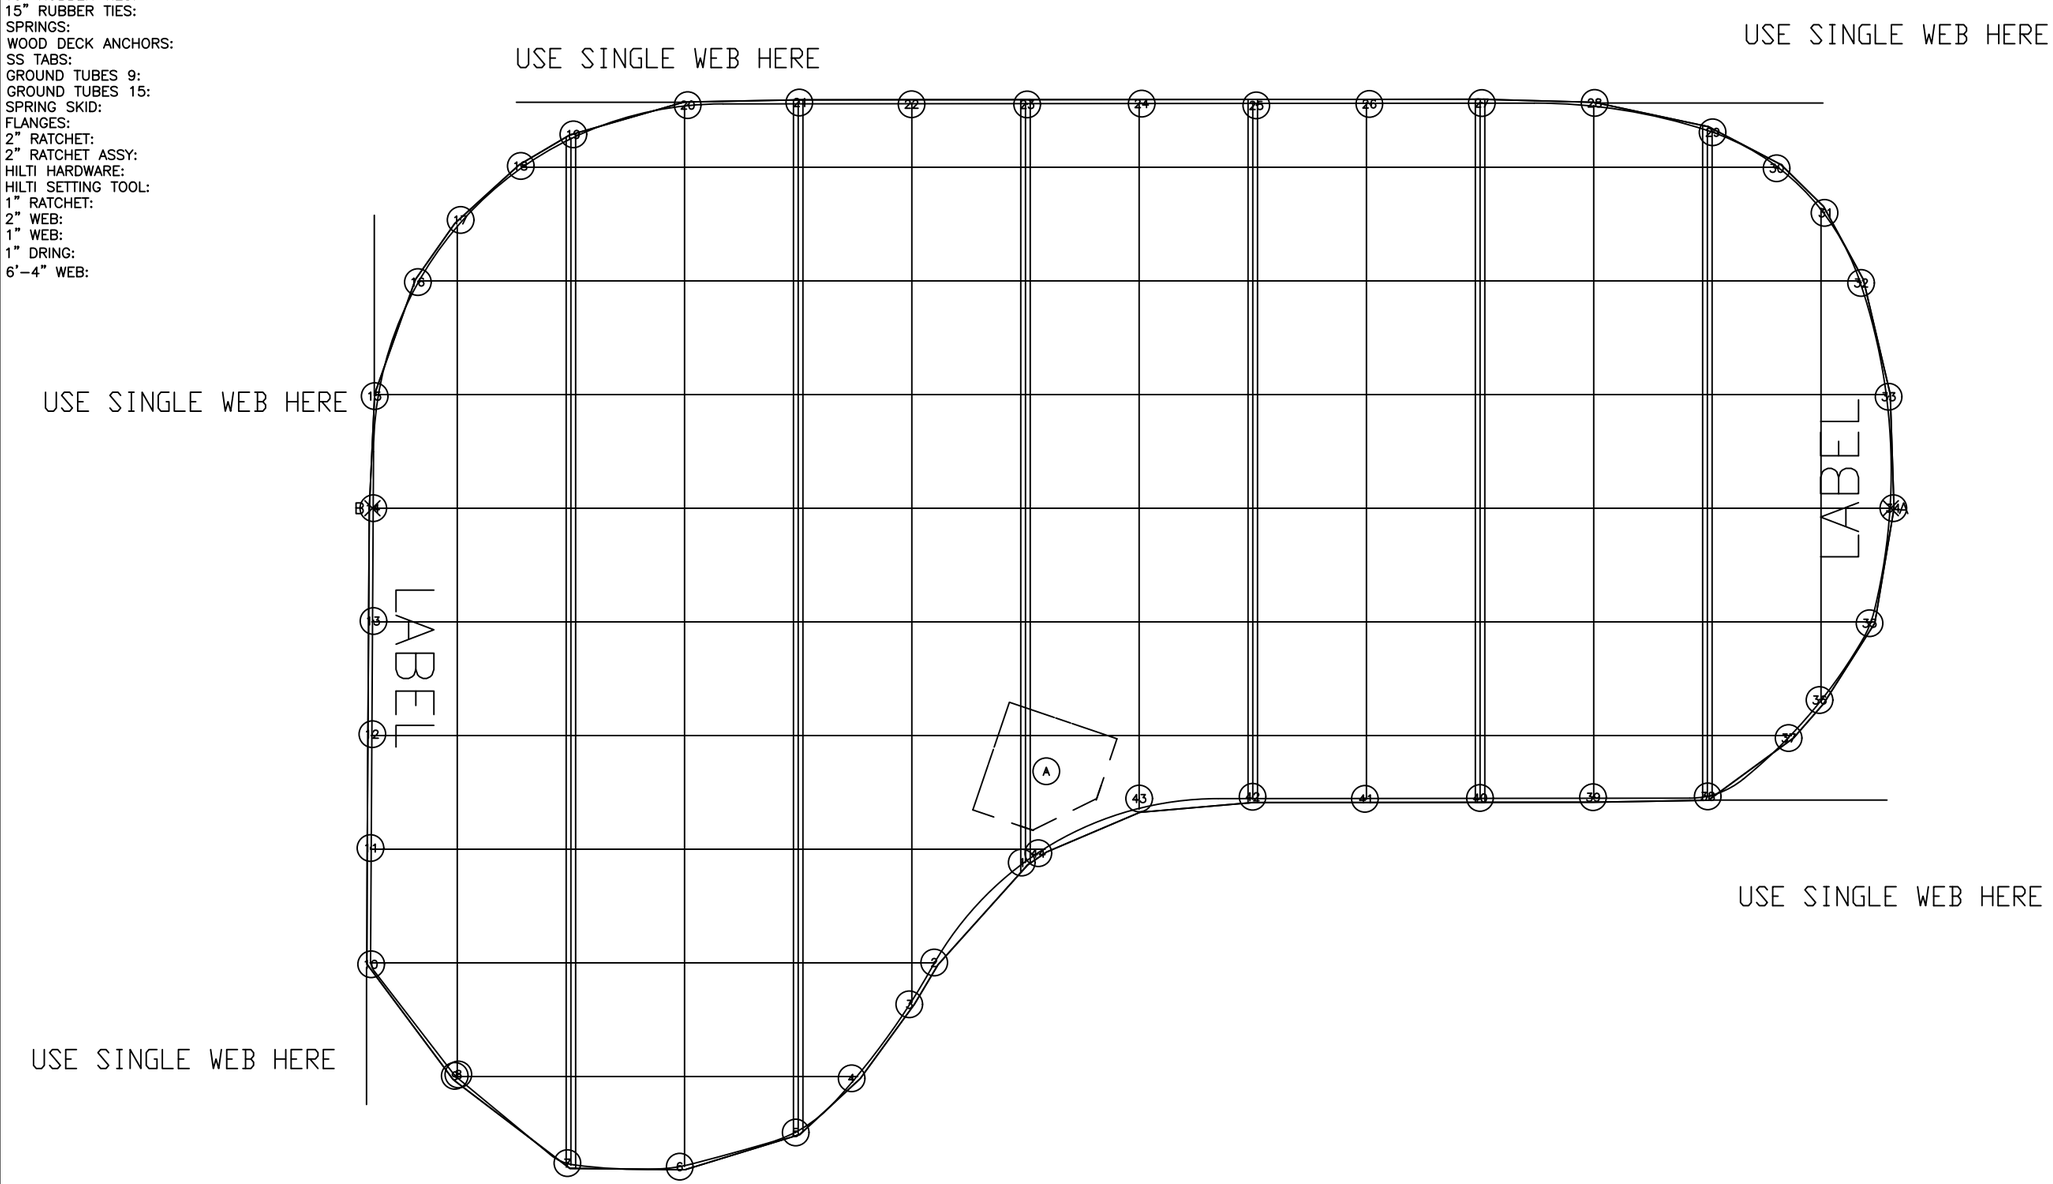

Fabric Lot			
Cutter		Hem	
Mark up		Tack	
Triple Needle/Weld		Vinyl Strap	
Cross Web		Tip/Grommet	
Stay Stitch		Inspect	

DESCRIPTION	TOTAL
S385 OUTSIDE CORNERS:	0
S390 DIAGONAL WEBS:	0
S113 GROMMETS:	0
S54 GA 9:	0
S53 GA 15:	0
CUT WEB ENDS:	0
CUT EDGE:	40'-3"
FINISH COVER:	40'-1"

435PR(LF):		450H:	
440SWR(LF):		455H:	
430IR(SF):		445H:	

A & B DISTANCES AS ENTERED

#	A	B	#	A	B
1	27'-6"	32'-5"			
2	24'-1"	33'-3"			
3	22'-11"	33'-5"			
4	20'-7"	34'-2"			
5	18'-7"	35'-2"			
6	15'-6"	37'-11"			
7	13'-2"	40'-10"			
8	13'	44'-2"			
9	12'-11"	44'-3"			
10	14'-7"	47'-2"			
11	17'-6"	48'-2"			
12	20'-5"	49'-3"			
13	23'-4"	50'-6"			
14	26'-3"	51'-11"			
15	29'-2"	53'-5"			
16	32'-4"	54'-2"			
17	34'-2"	54'-3"			
18	35'-11"	53'-11"			
19	37'-1"	53'-5"			
20	38'-9"	51'-9"			
21	39'-11"	49'-9"			
22	41'-2"	47'-9"			
23	42'-8"	45'-10"			
24	44'-4"	44'-1"			
25	46'-1"	42'-5"			
26	48'	41'			
27	50'	39'-9"			
28	52'-1"	38'-8"			
29	53'-10"	37'			
30	54'-6"	35'-8"			
31	54'-9"	34'-3"			
32	54'-5"	32'-3"			
33	53'-4"	29'-2"			
34	51'-11"	26'-3"			
35	49'-11"	23'-5"			
36	47'-10"	21'-10"			
37	46'-8"	21'-2"			
38	44'-1"	20'-8"			
39	41'-4"	22'-3"			
40	38'-8"	24'-1"			
41	36'	26'-2"			
42	33'-6"	28'-5"			
43	31'	30'-9"			
44	28'	32'-2"			
A	29'-6"	33'-2"			